


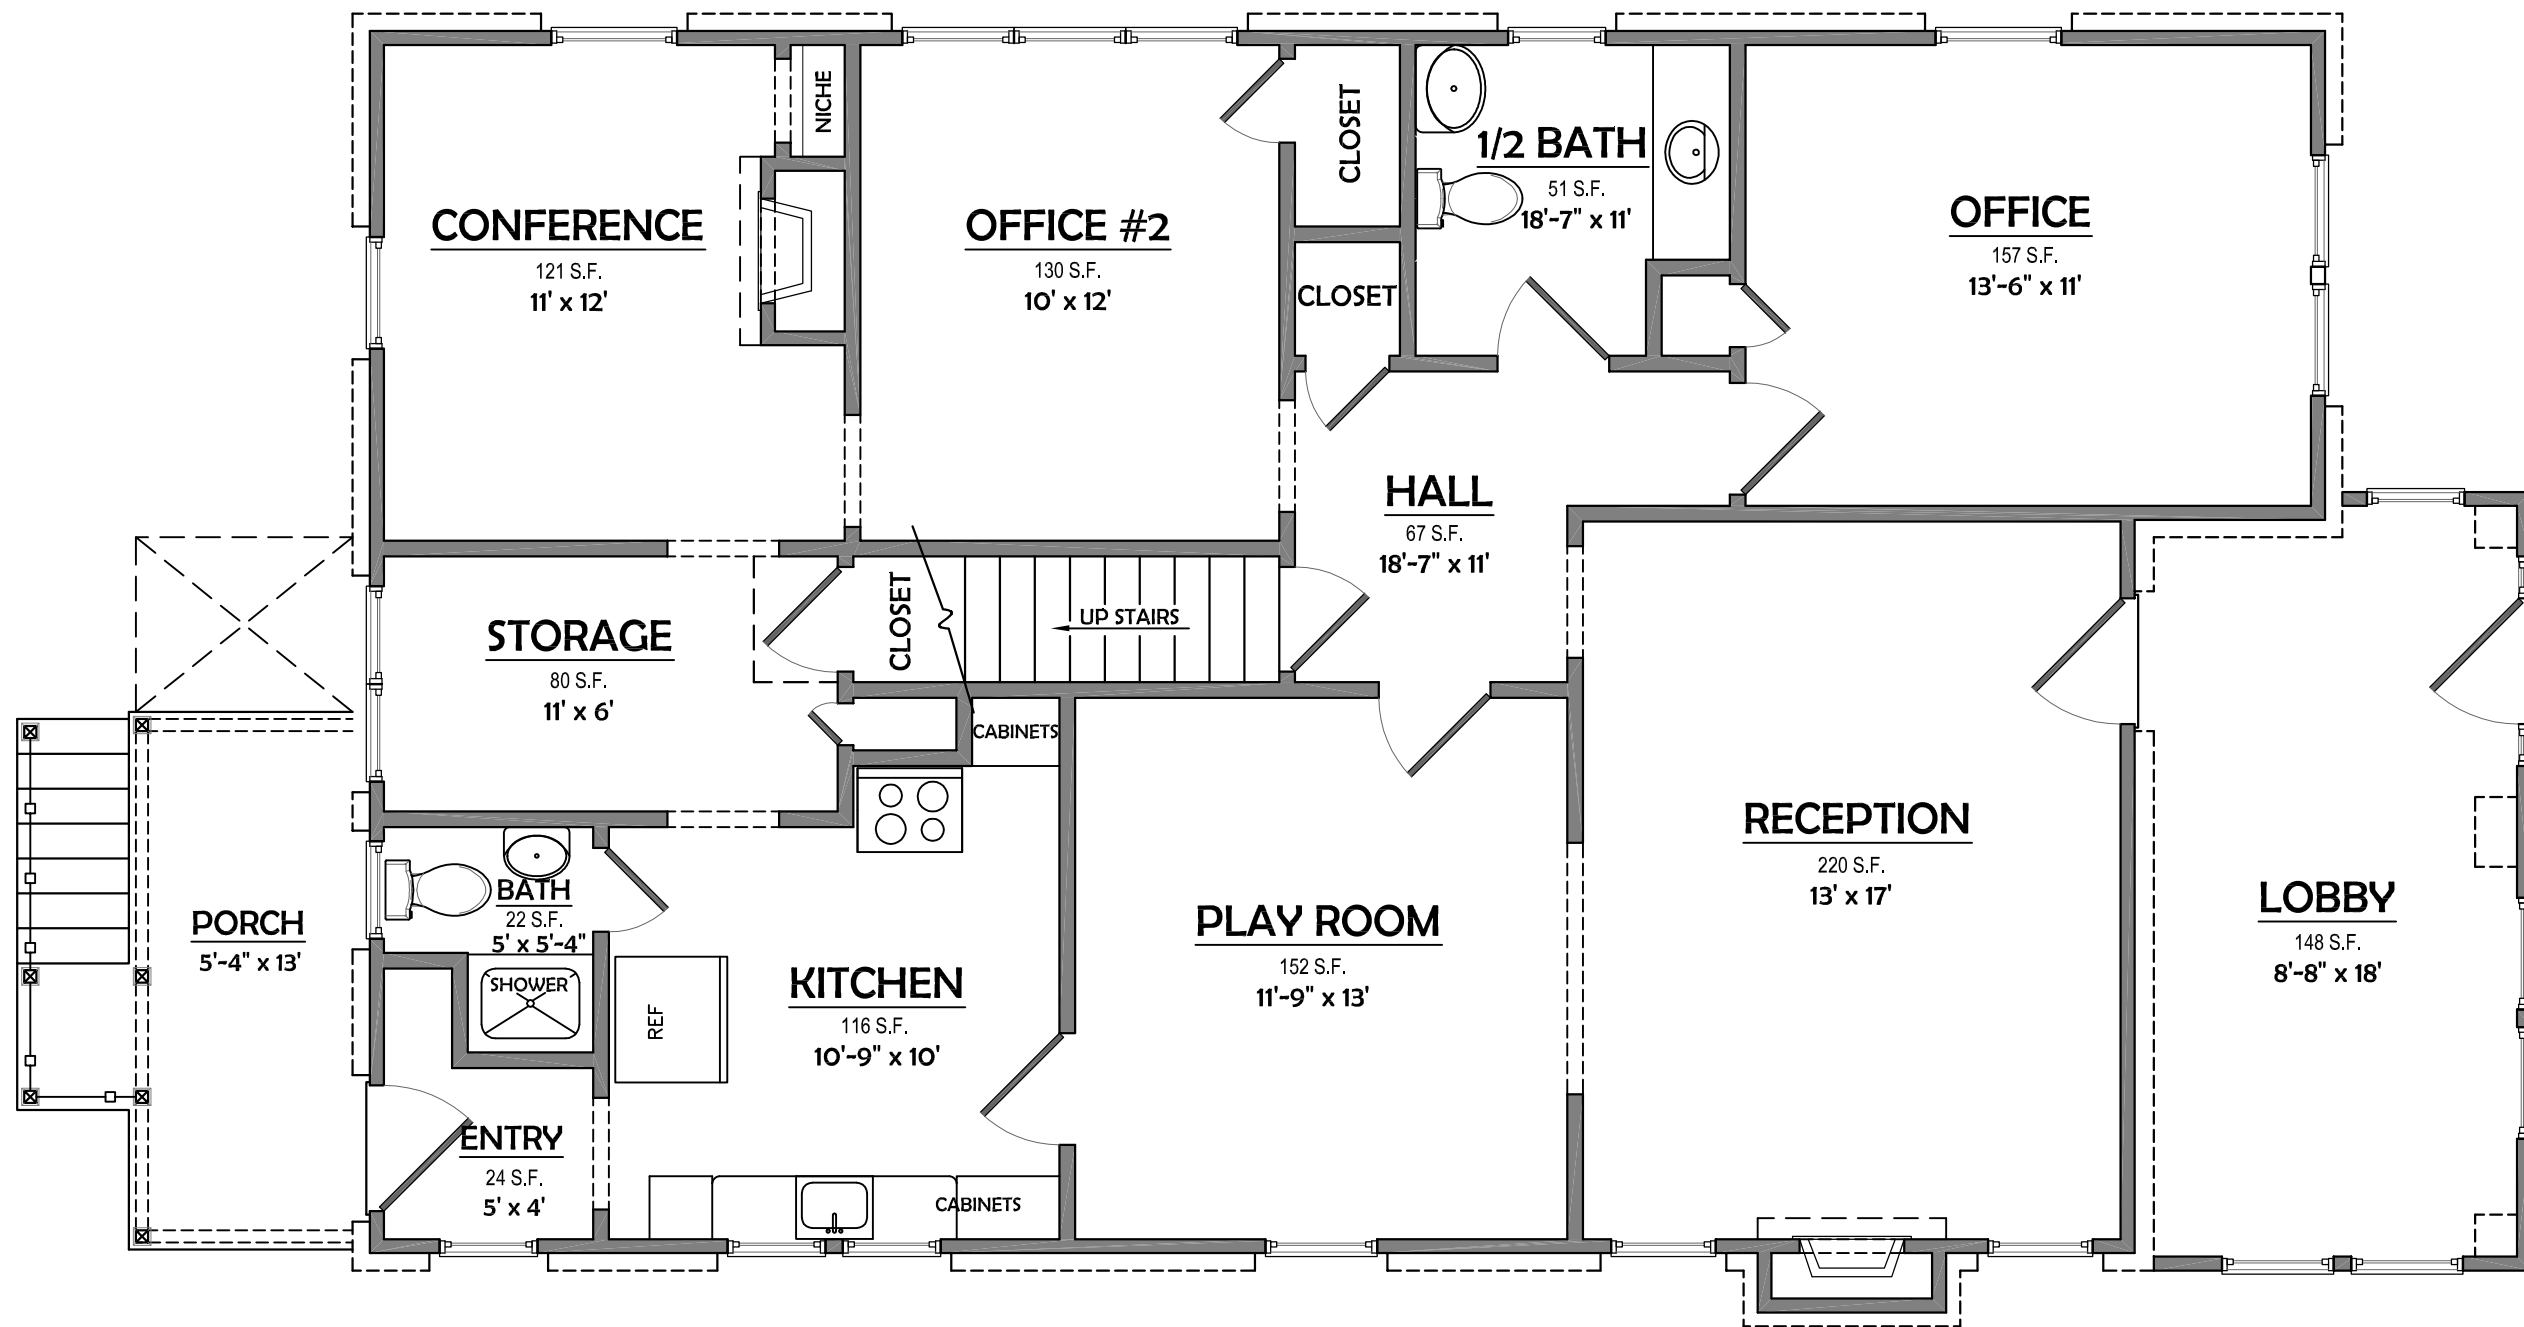

MAIN FLOOR



WALLBERG
CONSTRUCTION



PLANS ARE © COPYRIGHT 2021 BCDS, LLC
AND MAY NOT BE COPIED OR REDISTRIBUTED
WITHOUT WRITTEN CONSENT OF THE
DESIGNER. VALID THIS PROJECT ONLY.

AS-BUILT


ADDRESS:
219 E LEE ST. MARION

BUILT FOR:
TENANT

MAIN FLOOR: 1,444 sf
2nd FLOOR: 658 sf
BASEMENT: 1,262 sf
TOTAL LIVING: 3,364 sf

PRELIM SET: 10/12/21

A0.1
MAIN FLOOR

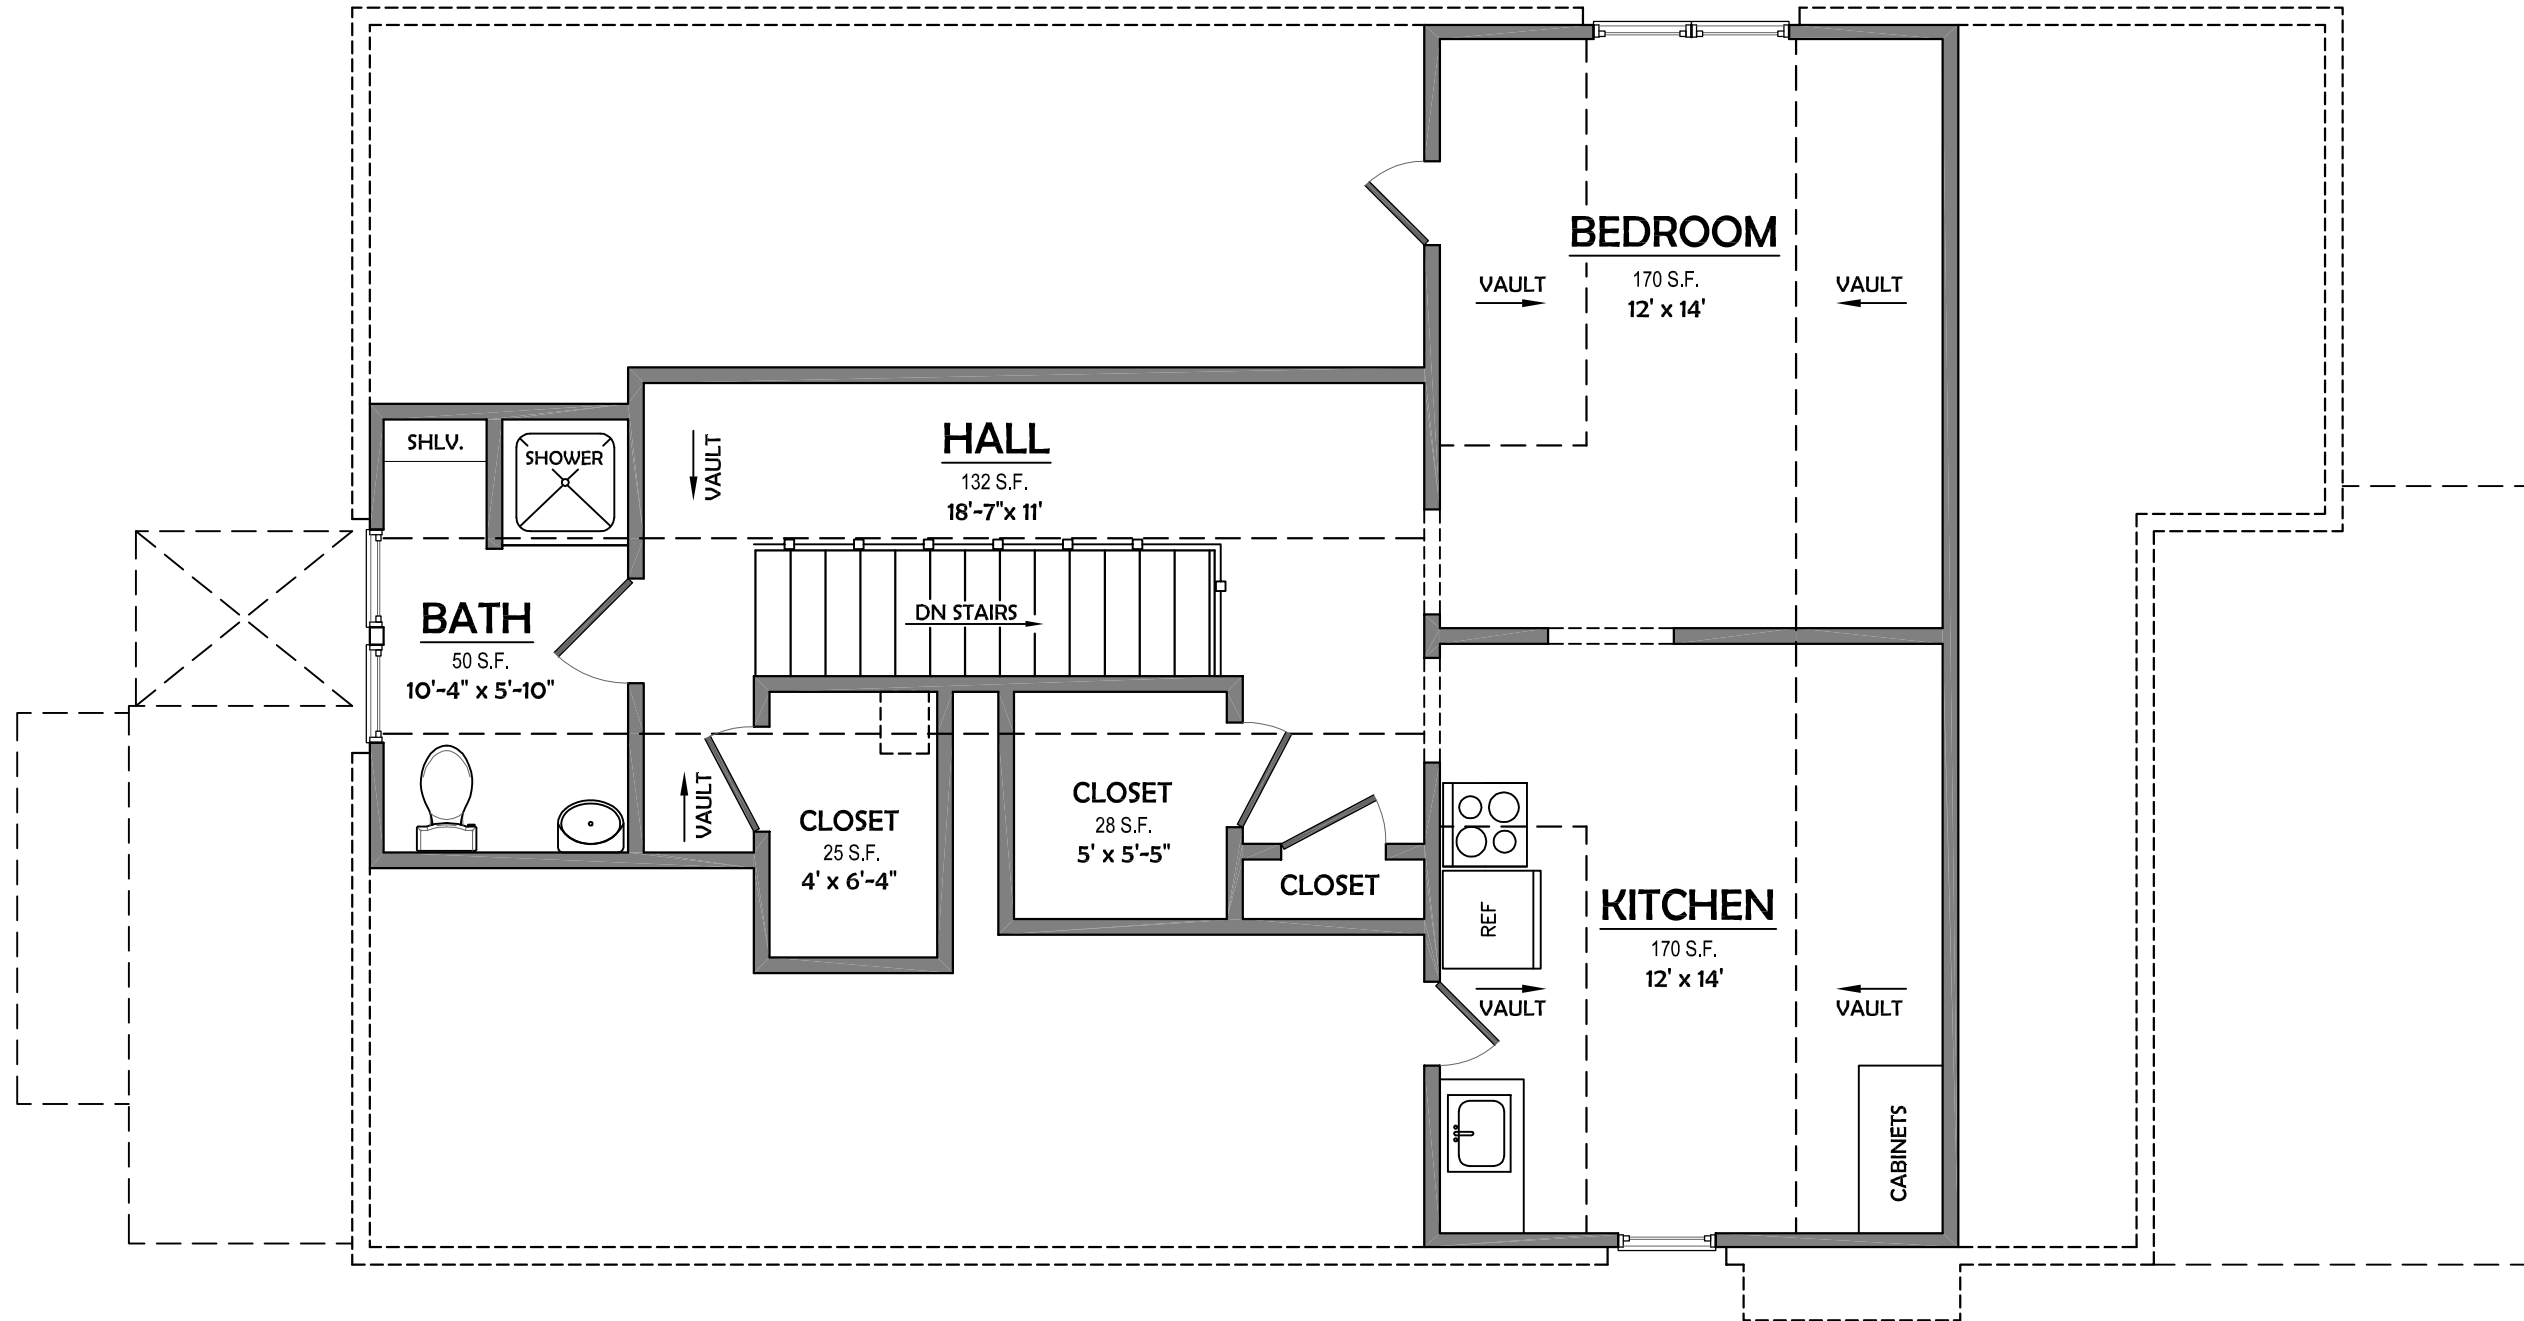

2ND FLOOR



WALLBERG
CONSTRUCTION



BCDS, LLC
276.565.8822

AS-BUILT
PLANS ARE © COPYRIGHT 2021 BCDS, LLC
AND MAY NOT BE COPIED OR REDISTRIBUTED
WITHOUT WRITTEN CONSENT OF THE
DESIGNER. VALID THIS PROJECT ONLY.


ADDRESS:
219 E LEE ST. MARION

BUILT FOR:
TENANT

MAIN FLOOR: 1,444 sf
2nd FLOOR: 658 sf
BASEMENT: 1,262 sf
TOTAL LIVING: 3,364 sf

PRELIM SET: 10/12/21

A1.1
2ND FLOOR

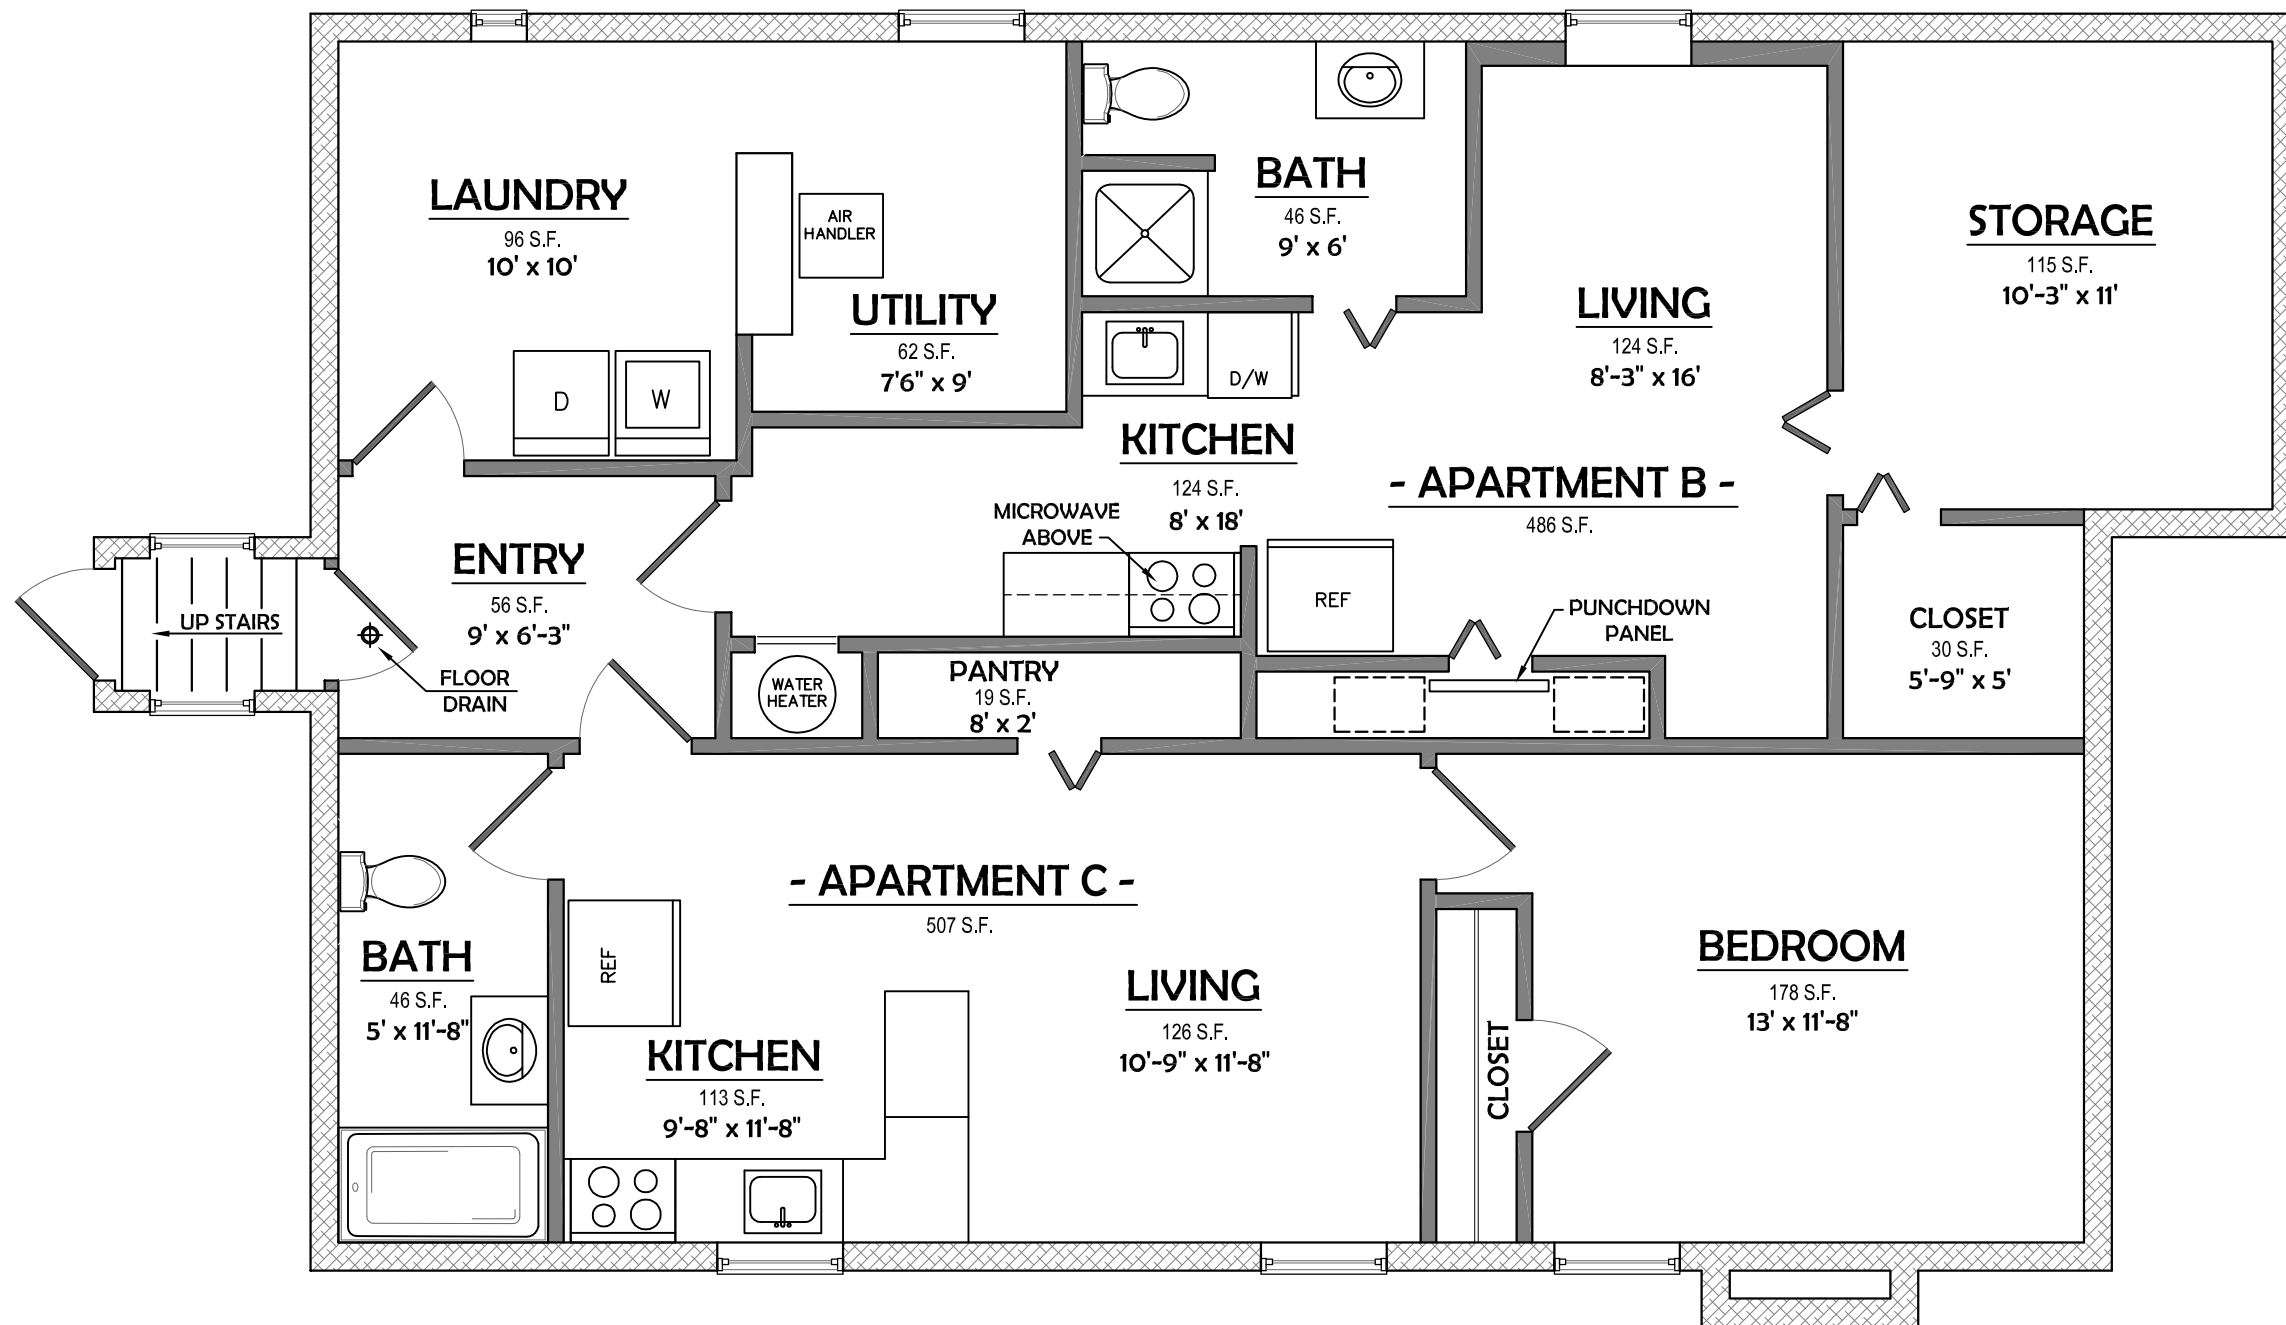

BASEMENT



WALLBERG
CONSTRUCTION

BCDS, LLC
276.565.8822

AS-BUILT
PLANS ARE © COPYRIGHT 2021 BCDS, LLC
AND MAY NOT BE COPIED OR REDISTRIBUTED
WITHOUT WRITTEN CONSENT OF THE
DESIGNER. VALID THIS PROJECT ONLY.

ADDRESS:
219 E LEE ST. MARION

BUILT FOR:
TENANT

MAIN FLOOR: 1,444 sf
2nd FLOOR: 658 sf
BASEMENT: 1,262 sf
TOTAL LIVING: 3,364 sf

PRELIM SET: 10/12/21

A1.2
BASEMENT